

SITE PLAN

DRAWN FOR:
NOBLE BUILT HOMES
 (503) 932-2619




1" = 20'

SUBDIVISION: MONITOR ROAD ESTATES LOT: 15 BLK: _____
 NAME: NOBLE BUILT HOMES PH. # 503-932-2619
 ADDRESS: _____ CDA: _____
 ASBUILT # _____ MAP # _____
 STORM DRAINAGE: _____
 WATER SERVICE LEVEL: _____ CODE: _____ PS: _____
 SIDEWALK: _____

APPROVAL STAMPS

Sidewalk 5' wide - 120' long

LOT 15
 8000 SF

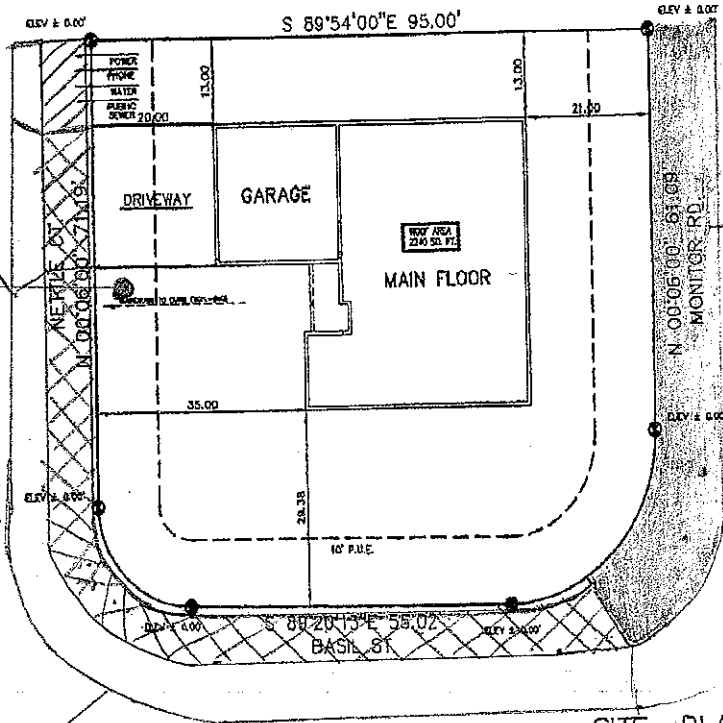

offset

existing sidewalk and planter strip

CITY OF SILVERTON
 PLAN REVIEW APPROVAL

PLANNING		
ENGINEERING		
PUBLIC WORKS	SRD	10/15/07
BUILDING DEPT.		
FIRE DIST.		

Planter strip
 3' to mark ↑

Sewer cleanout

Planter strip
 4' to mark ↑

Driveway 16'
 driveway wings 3'

Planter strip →
 6' to edge

SITE PLAN
 LOT 15, NETTLE CT.
 SALEM, OREGON
 SCALE: 1" = 20.00'

PLOTB = 20